


CONTROL UNIT + PWR SUPPLY ARRANGEMENT

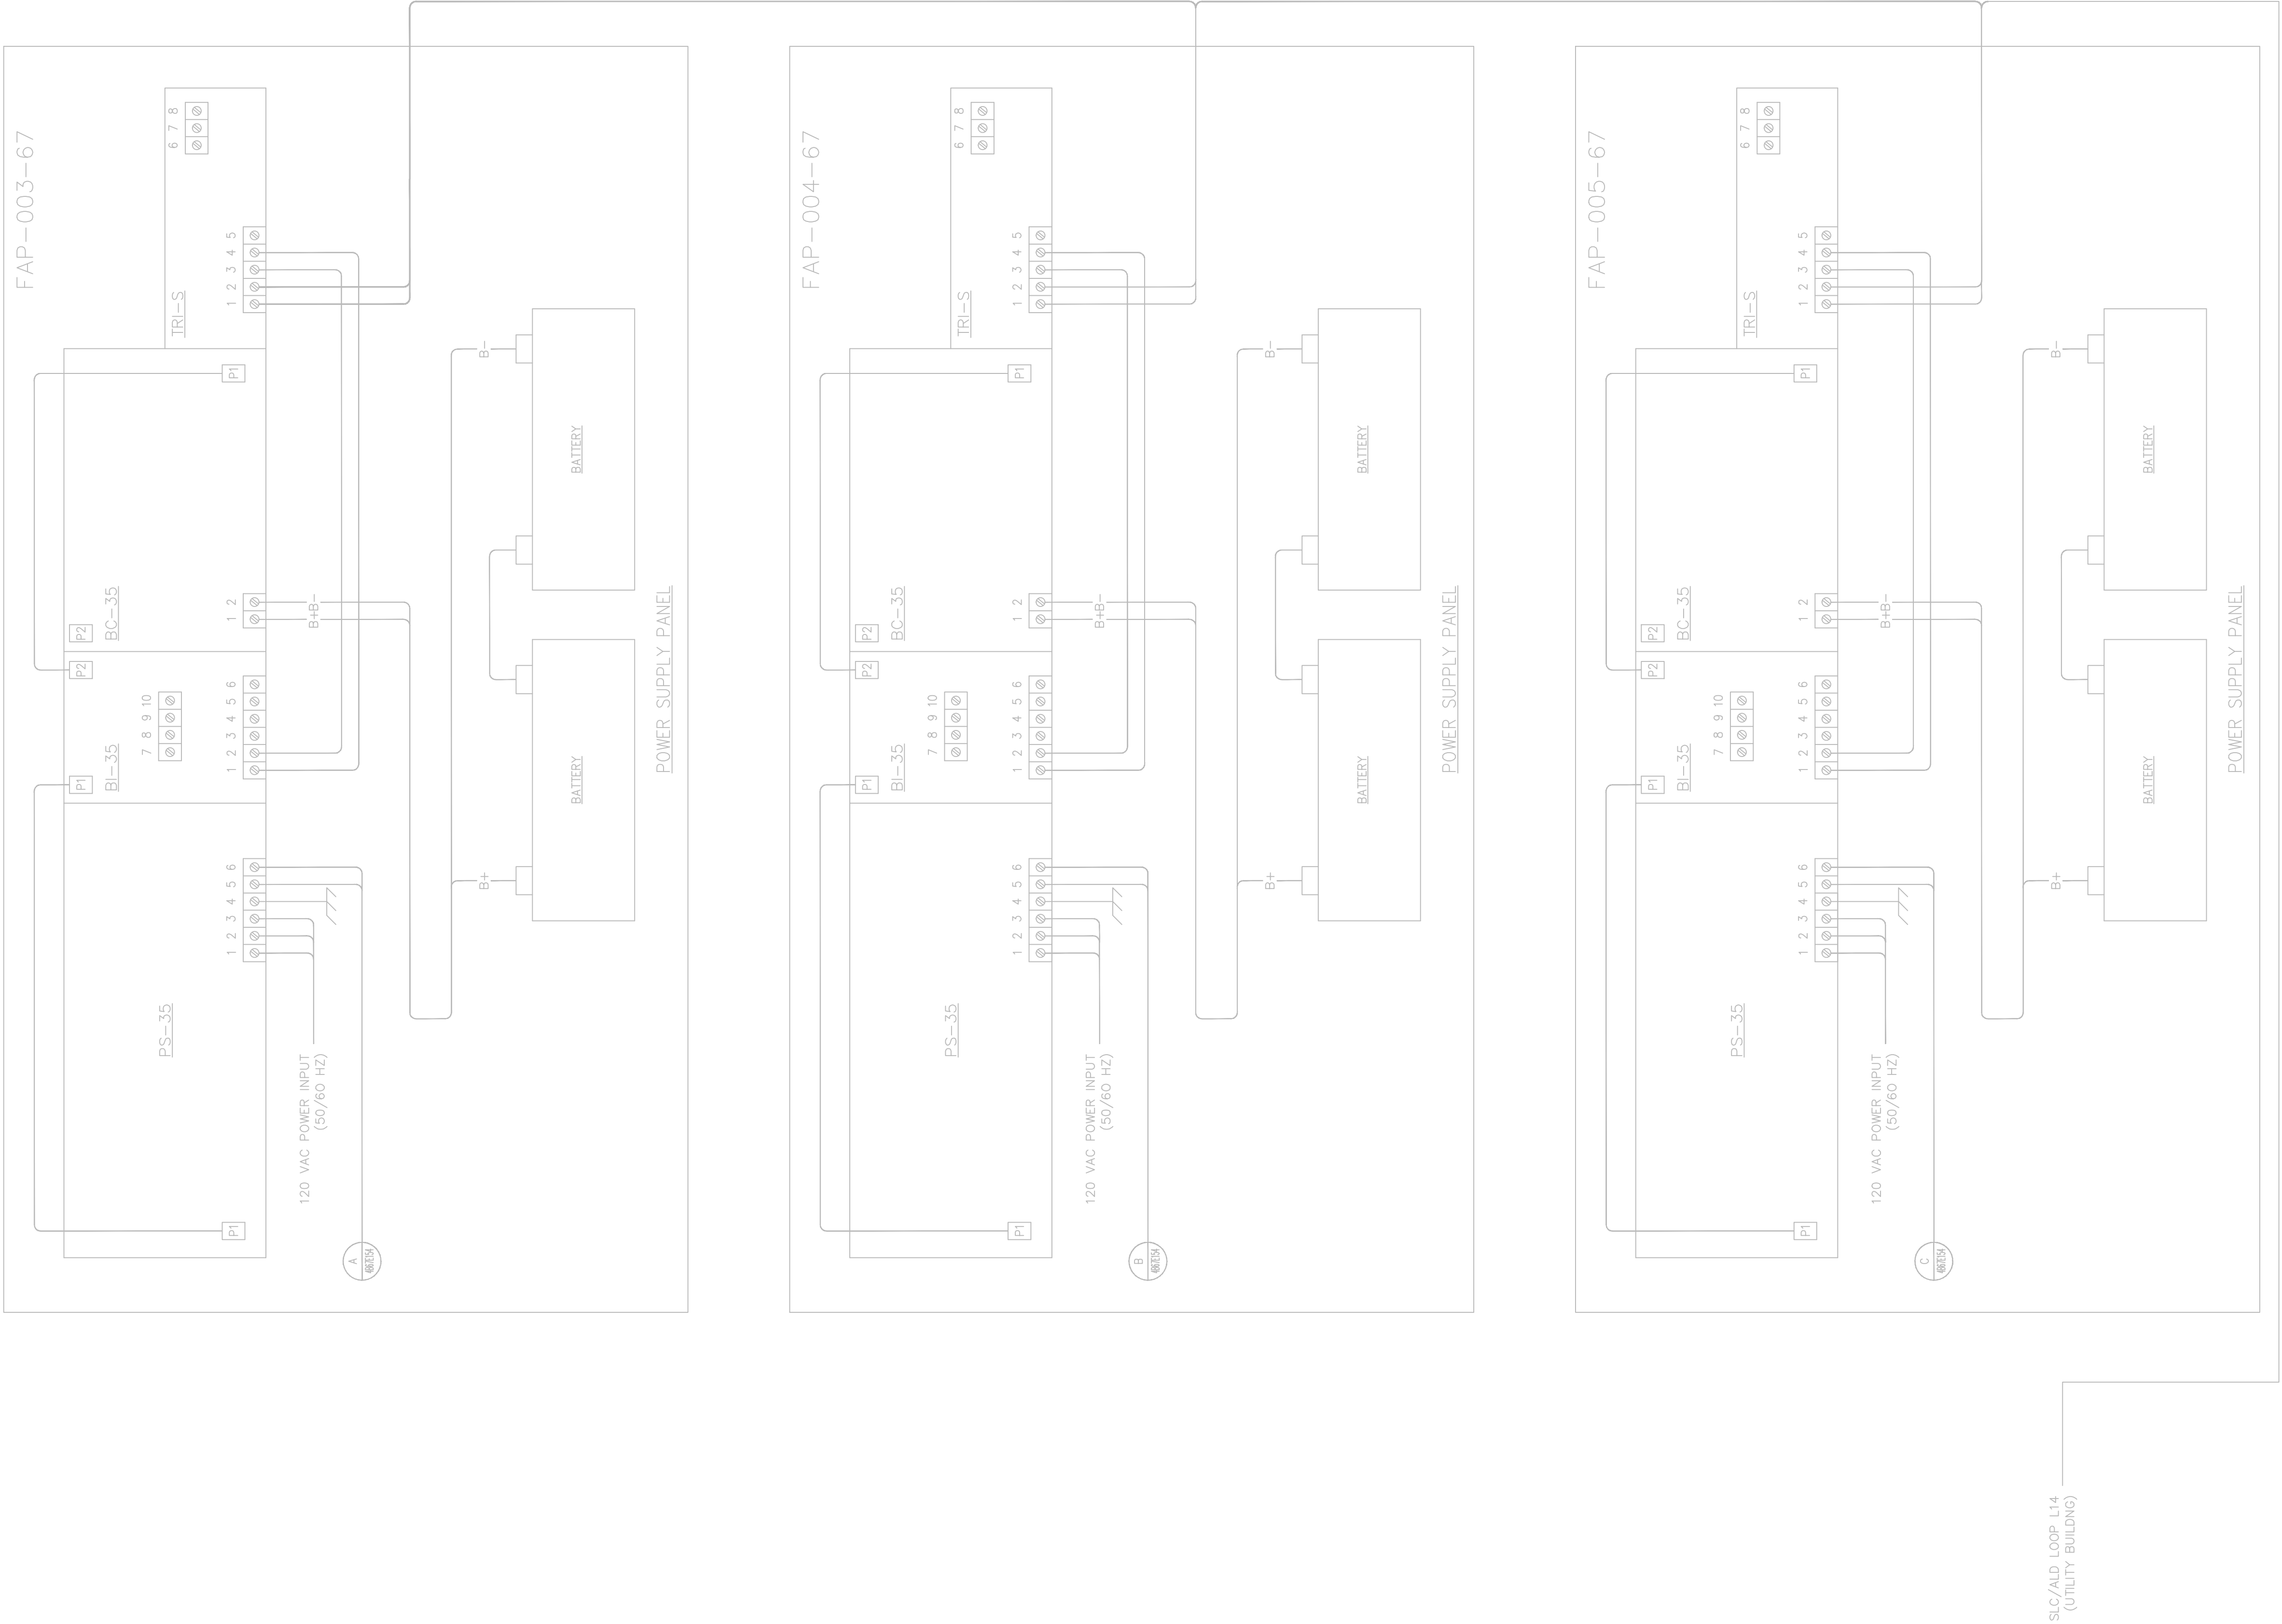

PROFESSIONAL SEAL (IF REVISION, APPLIES ONLY TO REVISED WORK)	AS BUILT 06/17/13								BLDG-67 FIRE ALARM CONTROL UNIT & PWR SUPP ARRANGEMENT FAP-003,004,005-67	DRAWN BY	DSV	DATE	06/17/2013	
										CHECKED BY	LDD	7/8/2013		
										APPROVED BY	MCD	7/8/2013		
												SCALE		
												DRAWING NO.	4B67E155	SHEET
UNIVERSITY OF CALIFORNIA LAWRENCE BERKELEY NATIONAL LABORATORY FACILITIES DIVISION										PROJECT NO. FN1438		8 OF 21		
ISSUE		(PROGRESS, ESTIMATE, BID, CONSTRUCTION, CONFORMED, REVISION, RECORD)		REVISION NUMBER	DRAWN BY	CHECKED BY	APPR'D BY	DATE	REMARKS					
-					DSV	LDD	MCD	6/17/13	AS BUILT PER FIELD VERIFICATION					